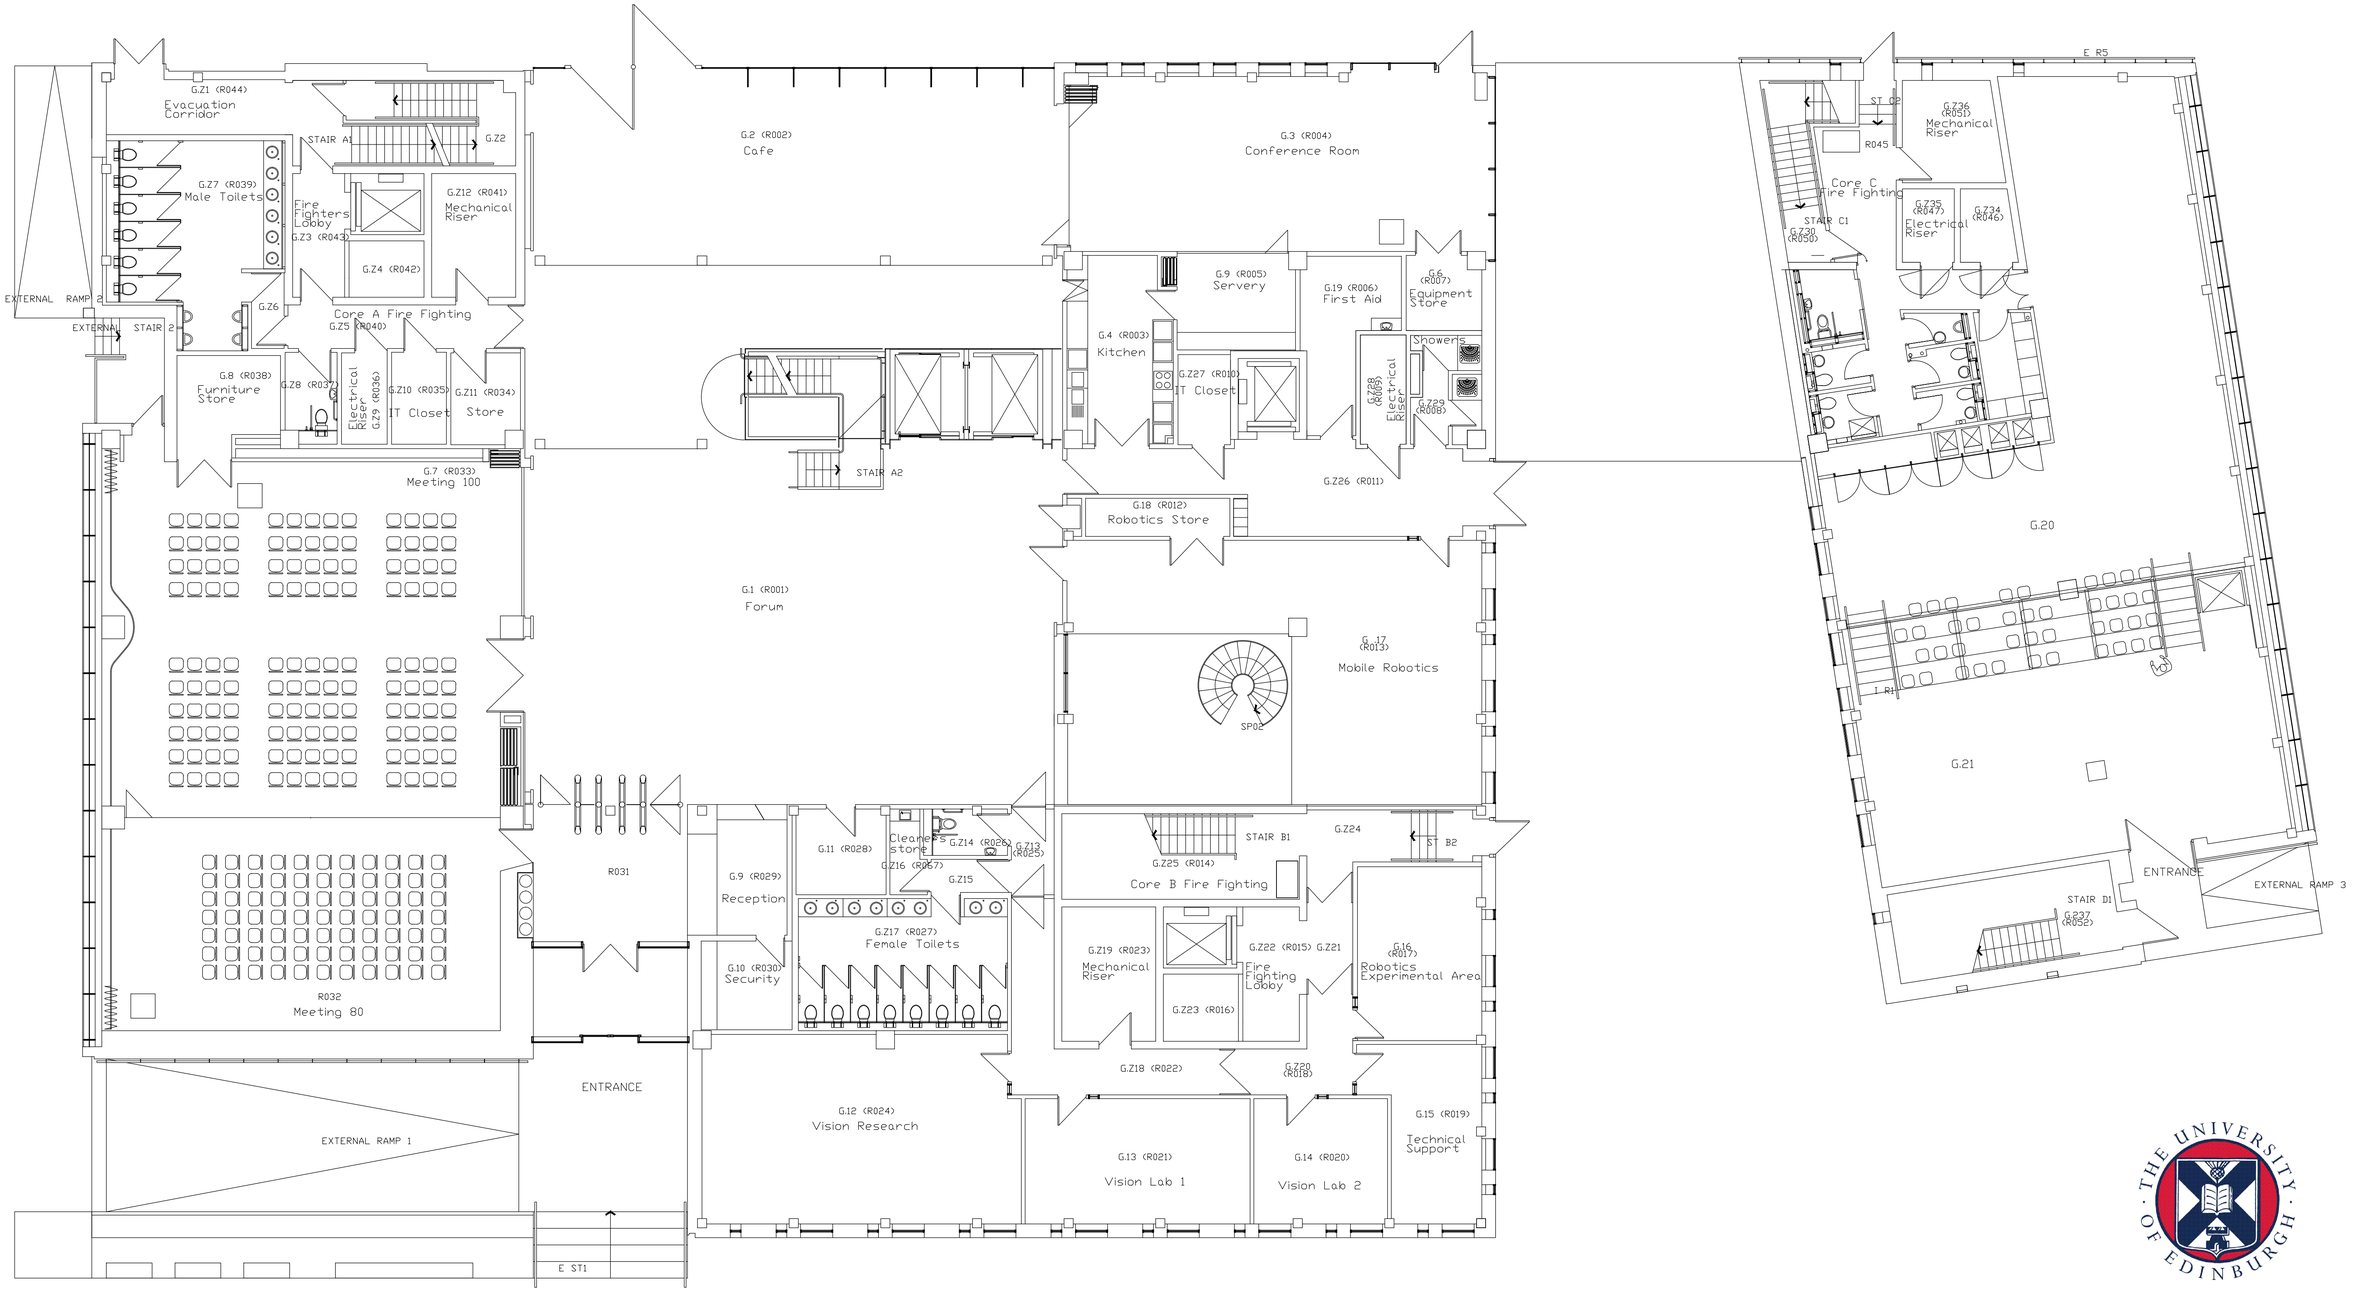

THE UNIVERSITY OF EDINBURGH

UNIVERSITY of EDINBURGH
ESTATES & BUILDINGS
WORKS DIVISION
9-11 INFIRMARY STREET
EDINBURGH EH1 1NP Tel 0131 650 2469

Department
Phase 2 Informatics

Project
Upgrading of Record Drawings

Drg Title
Floor Plan Level 02

Drn By BTM	Date Feb 2008
Scale 1:100	Bld No 0282

Drg No R028202 Rev 0