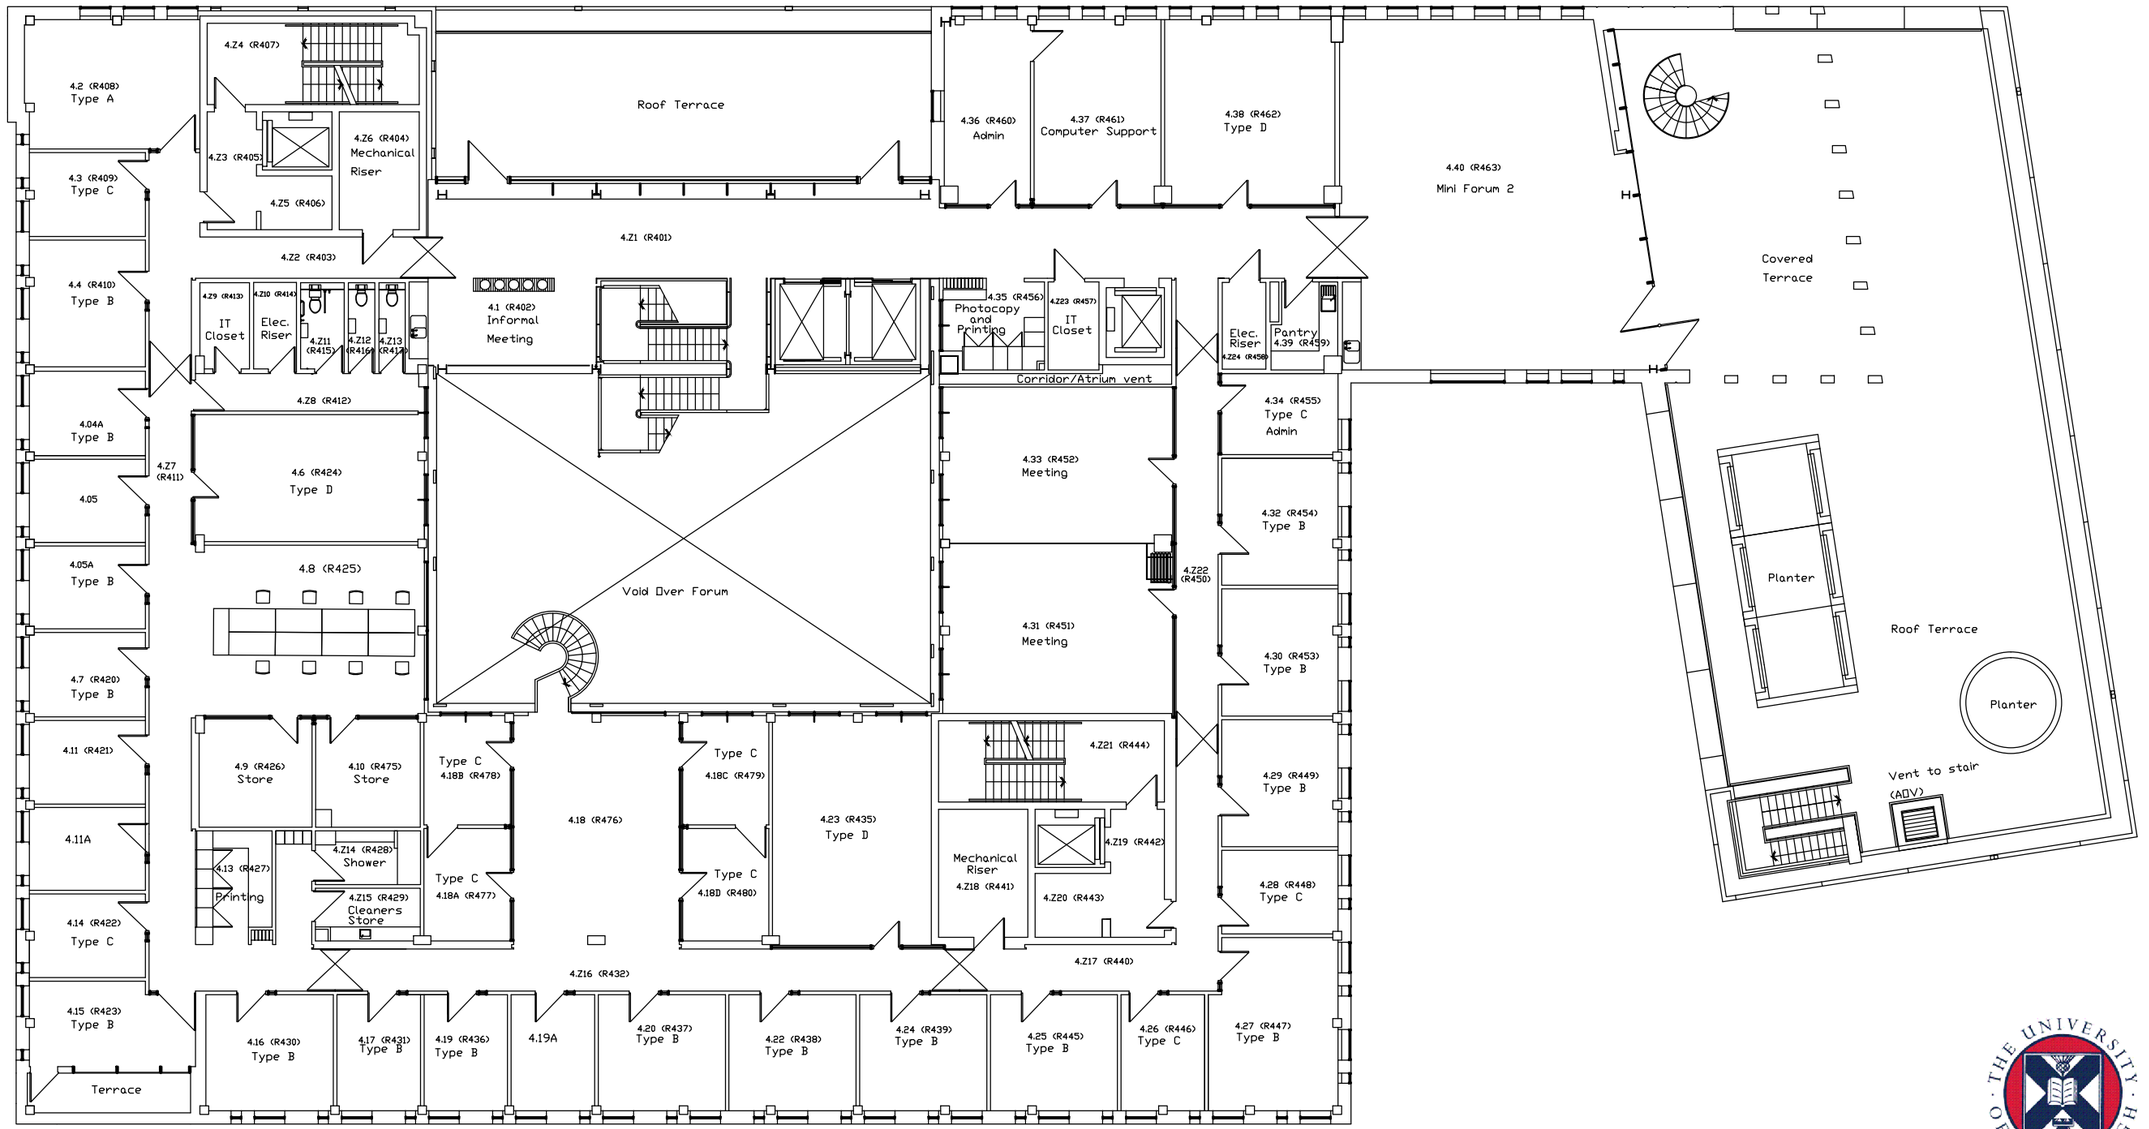

THE UNIVERSITY OF EDINBURGH

UNIVERSITY of EDINBURGH
ESTATES & BUILDINGS
WORKS DIVISION
9-11 INFIRMARY STREET
EDINBURGH EH1 1NP Tel 0131 650 2400

Department
Phase 2 Informatics

Project
Upgrading of Record Drawings

Drg Title
Floor Plan Level 06

Drn By BTM	Date Feb 2008
Scale 1:100	Bld No 0283

Drg No R028206 Rev 0